



U.S.S. CG 11

This Booklet Of General Plans was
obtained from the National Archives
and Records Administration.
They are donated by crewmembers of
USS Chicago (CG-11).

ORDER OF PLANS	PLATE NO
COVER SHEET	1
GENERAL INFORMATION	2
OUTBOARD PROFILE	3
INBOARD PROFILE	4
06 LEVEL & ABOVE	5
03, 04 & 05 LEVELS	6
02 LEVEL	7
01 LEVEL	8
MAIN DECK	9
SECOND DECK	10
THIRD DECK	11
FIRST PLATFORM	12
SECOND PLATFORM	13
HOLD	14
INNER BOTTOM	15
TYPICAL SECTIONS	16

[illegible]

BOOKLET OF
GENERAL PLANS
SELECTED RECORD PLAN

CG 11 - 845 - 1072834

DATE _____ APPROVED _____

CONFIDENTIAL

HULL DIMENSIONS

* LENGTH, BETWEEN PERPENDICULARS	664'-0"
* LENGTH, OVERALL	674'-9 1/2"
* BREADTH, EXTREME	69'-11 1/4"
* DRAFT, ABOVE BOTTOM OF KEEL (DWL)	22'-0"
* DRAFT, ABOVE LOWEST PROJECTION BELOW KEEL (DWL) SONAR DOME	28'-8 1/4"
* KEEL THICKNESS	0'-2"
* FRAME SPACING	4'-0"

HEIGHTS ABOVE (DWL) 22'-0" ABV MBL

* TOP OF STUBMAST (MCJR ANT)	195'-0"
* TOP OF AS-514/URD-4 ANT ON TOP OF FOREMAST (IN RAISED POSITION)	192'-10"
* C OF FWD ANCHOR LIGHT	52'-10"
* C OF AFT ANCHOR LIGHT	37'-7"
* C OF STEERING LIGHT ABT	50'-7 5/8"
* C OF SIDE LIGHTS P/S	82'-4 7/8"
* C OF MASTHEAD LIGHT	96'-1 7/8"
* C OF RANGE LIGHT	117'-5 7/8"
* C OF BLINKER LIGHT P/S	125'-9 5/8"
* C OF TOWING LIGHTS	UPPER 123'-5 7/8" LOWER 111'-5 7/8"
* C OF AIRCRAFT WARNING LIGHTS P/S FR 96 1/4	125'-4 1/4"
* C OF MANOVERBOARD AND BREAKDOWN LIGHTS (TASK LIGHTS) UPPER 186'-9" MIDDLE 180'-9" LOWER 174'-9"	
* C OF SPEED LIGHTS & AIRCRAFT WARNING LIGHTS P/S FR 78 1/2	SPEED 164'-8" AIRCRAFT 163'-10"
* C OF STERN LIGHTS	BLUE (S) 20'-5/8" WHITE (P) 22'-7 1/2"
* C OF WAKE LIGHT	25'-10"

* MEASURED DIMENSIONS


ACCOMMODATIONS


PERSONNEL	BEDS	TRANSOM BERTHS	BERTHS	BERTH LOCKERS	TYPE "A" LKRS
CAPTAINS SEA CABIN		1			
FLAG SEA CABIN		1			
CAPTAINS STATEROOM	1				
FLAG STATEROOM	1				
CHIEF OF STAFF STATEROOM	1				
EXECUTIVE OFFICERS STATEROOM	1				
SHIPS OFFICERS STATEROOMS		8			
WARDROOM STATEROOMS			72		
CREWS LIVING SPACES			1107	1107	
C.P.O. LIVING SPACES			67		67
MARINES LIVING SPACE			42	42	
SICK BAY WARD			16		
ISOLATION WARD			4		
TOTAL	4	10	1280	1121	67

GRAND TOTAL MINUS SEA CABINS AND WARDS 1100.




SMALL BOATS

NO	NAME	MEN EACH	TOTAL MEN
2	14' PUNTS (PLASTIC)	5	10
1	33' PERSONNEL BOATS (PLASTIC) MK 2	24	24
3	40' UTILITY BOATS (PLASTIC) MK 3	75	225
1	40' PERSONNEL BOAT MK 2	43	43
81	CO2 INFLATABLE LIFEBOATS	15	1215
2	26' MOTOR WHALEBOATS	20	40
GRAND TOTAL MINUS 14' PUNTS - 1547		TOTAL	1557

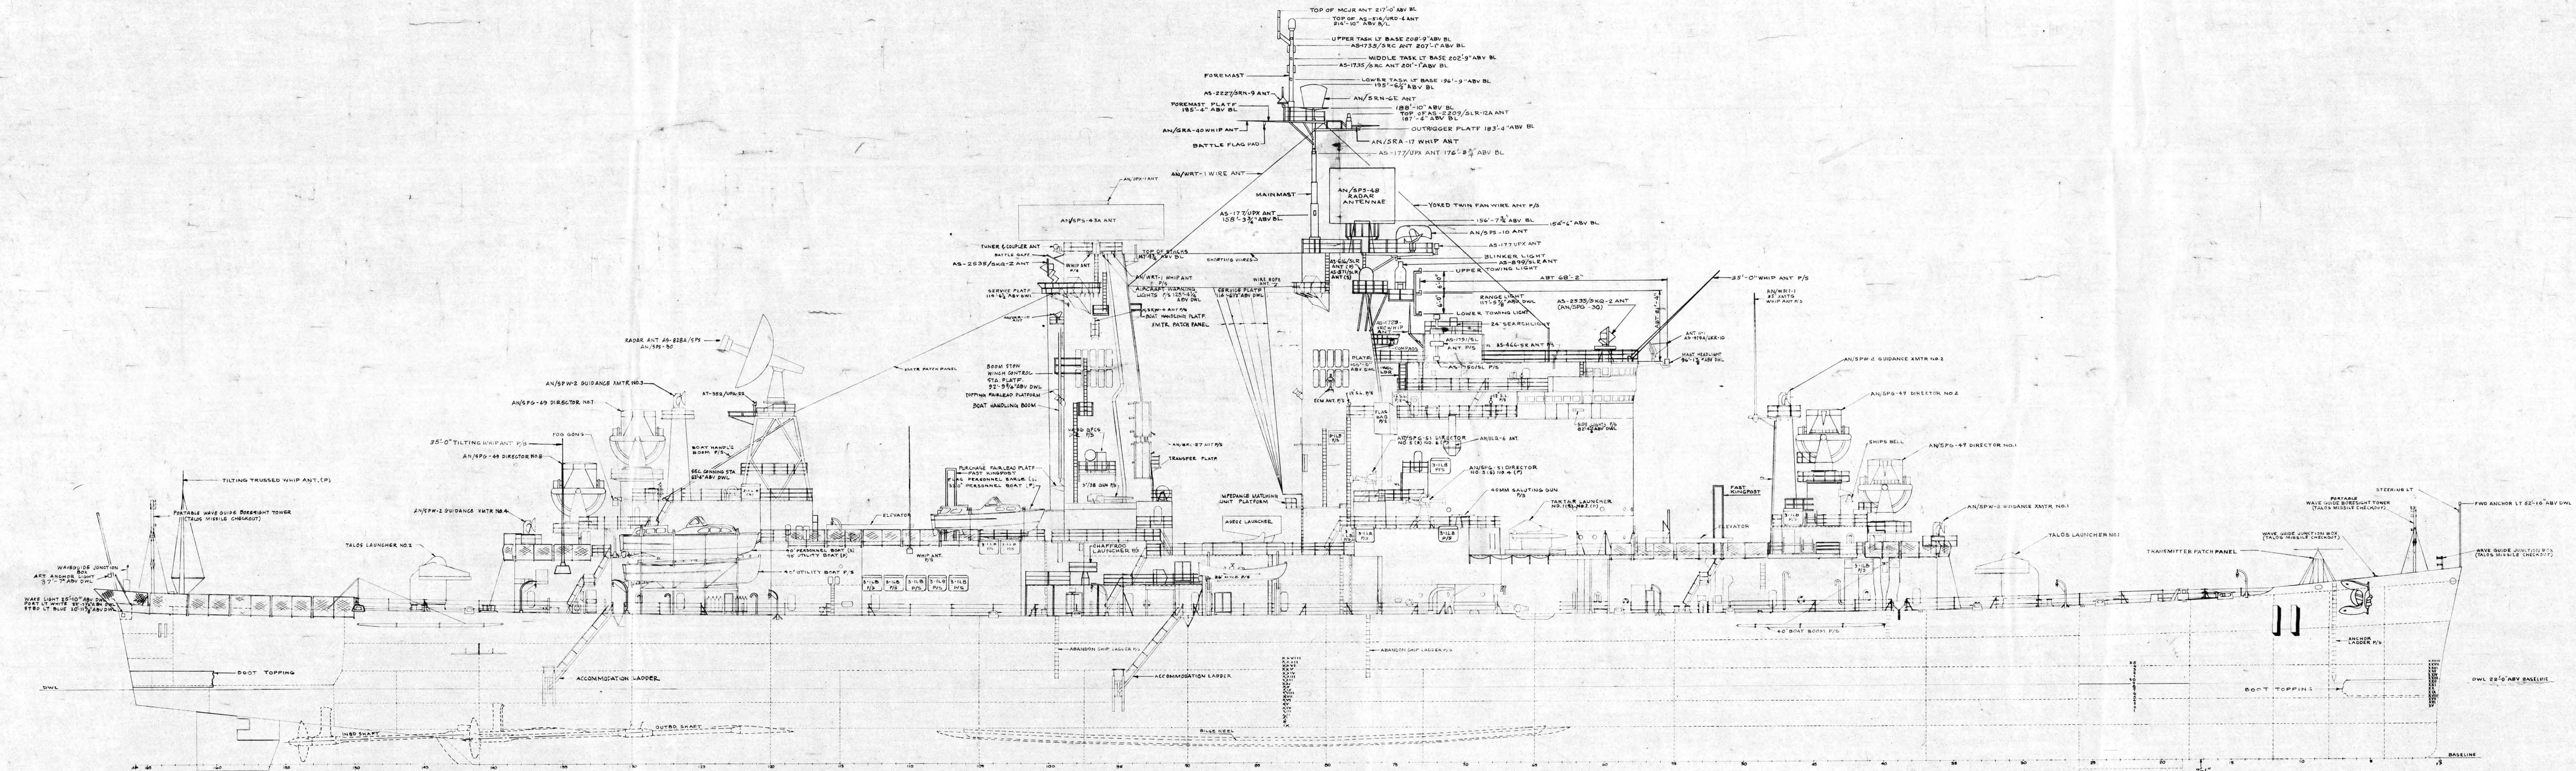


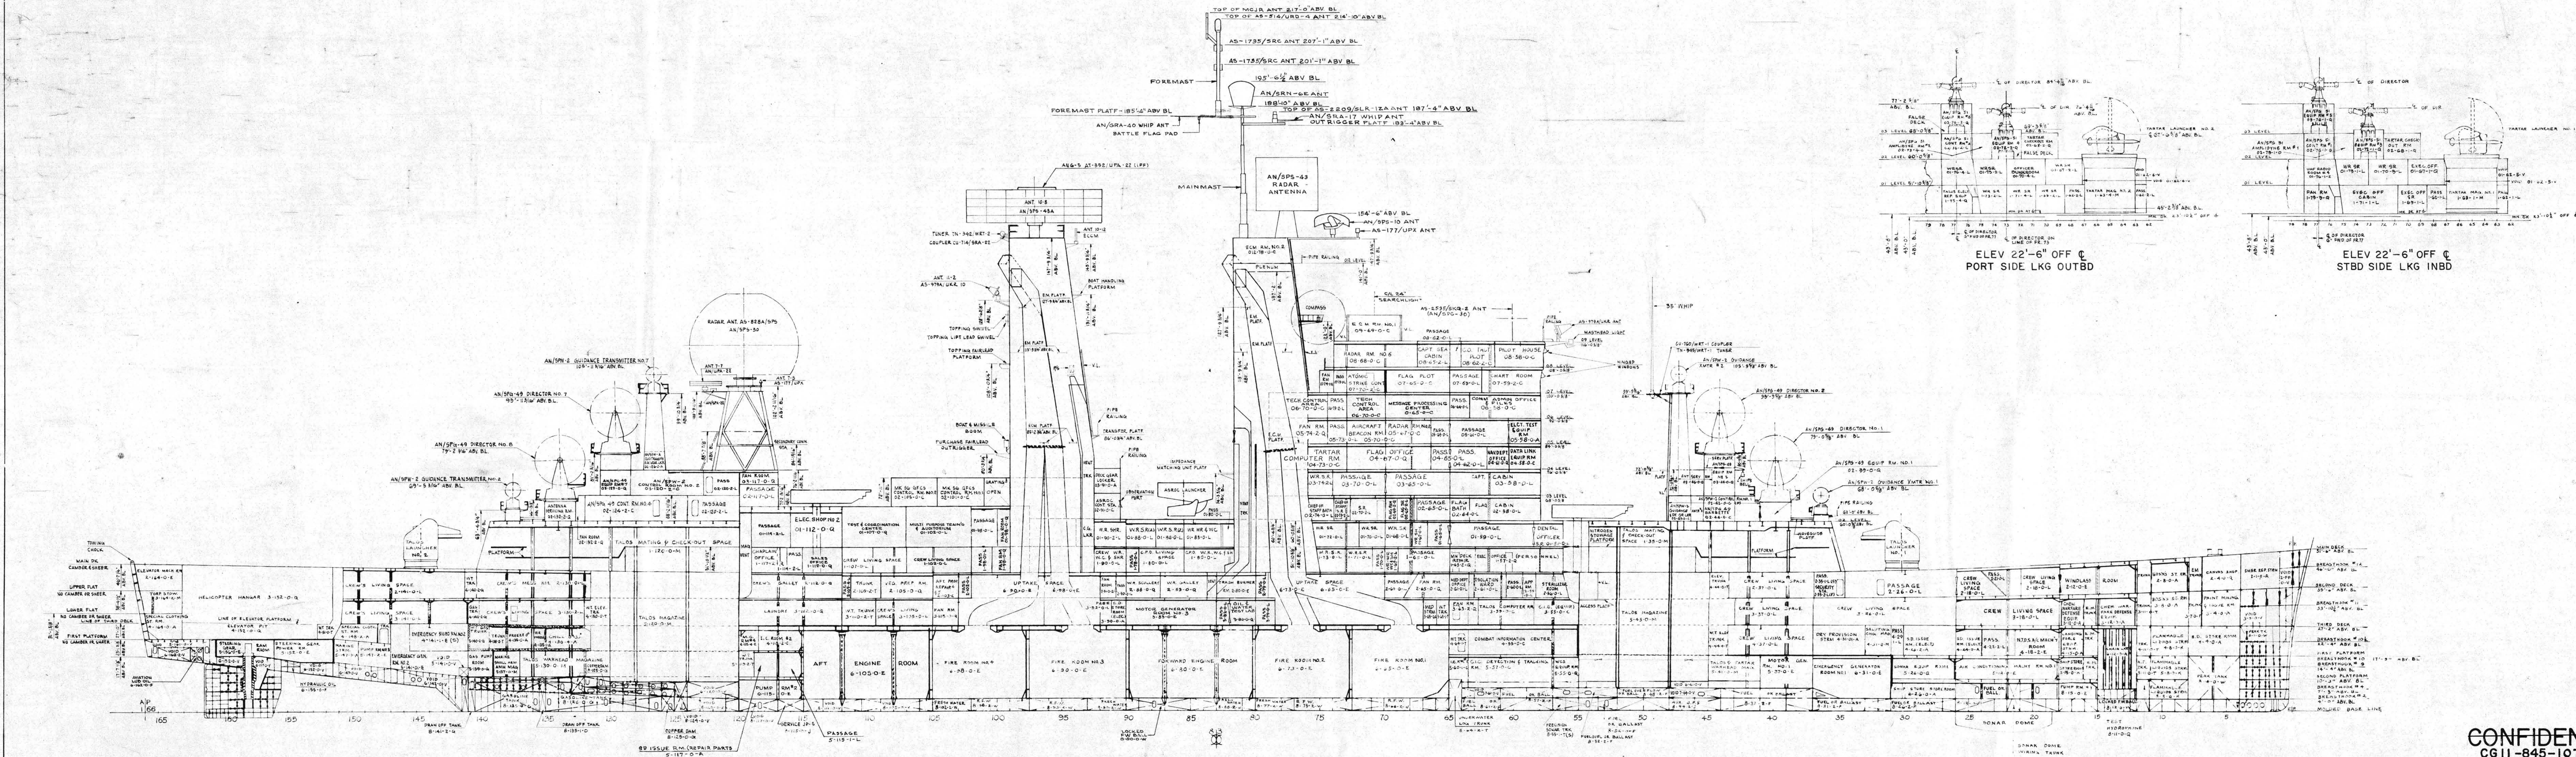

~~CONFIDENTIAL~~

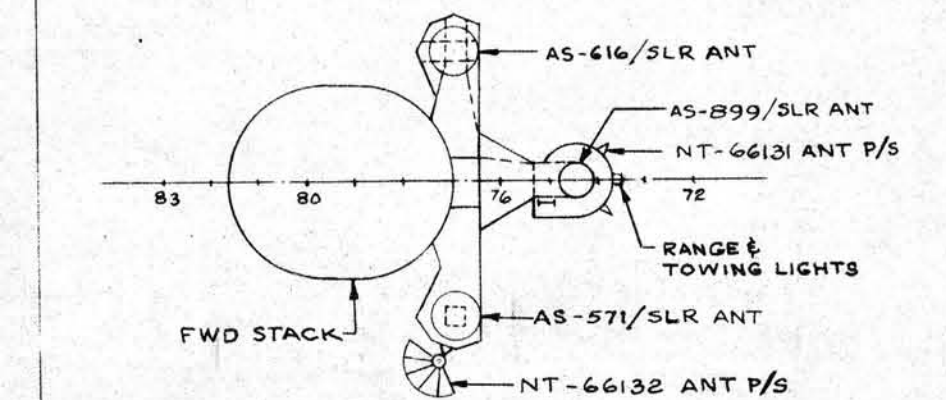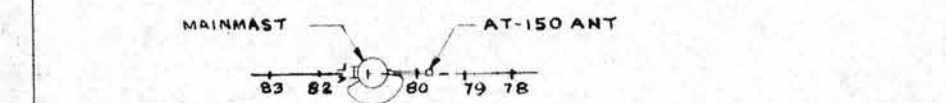
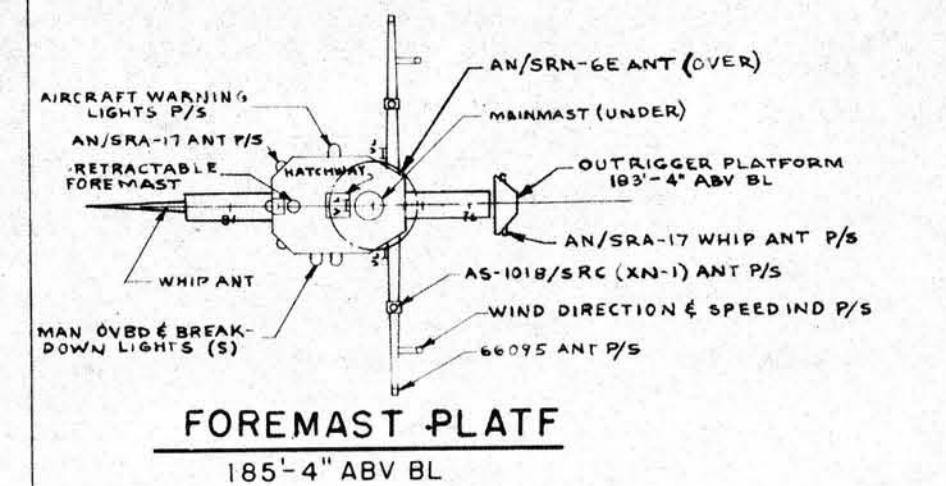


ANTENNA PLATFORM
ABT 134'-7" ABV BL

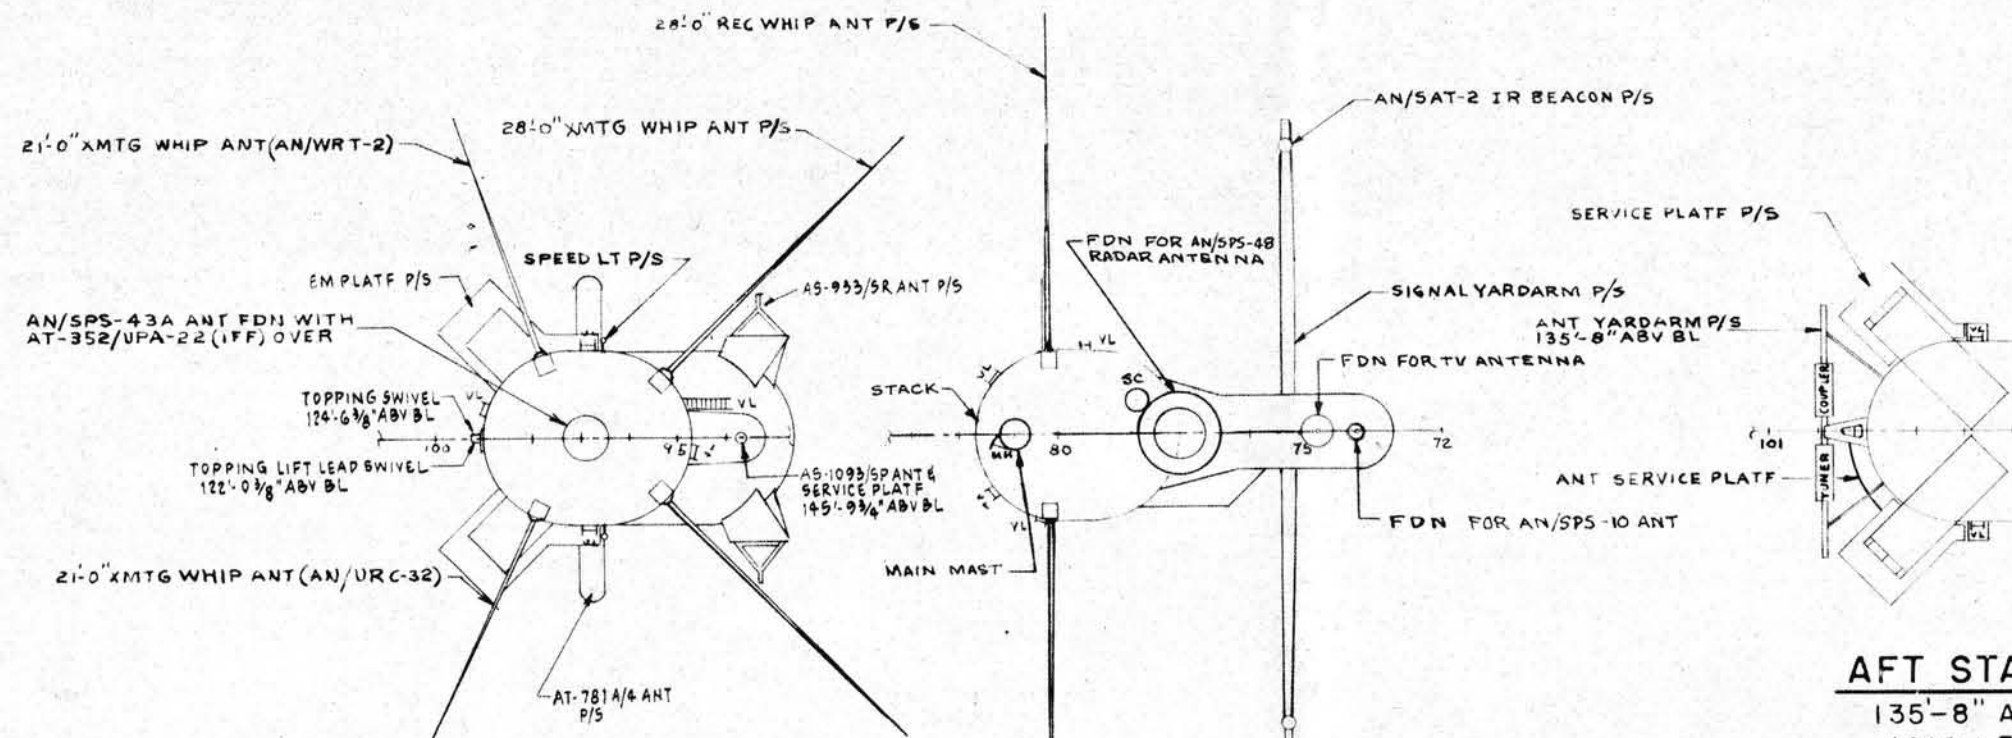

TOP OF AFT
STACK
147'-9 3/4" ABV BL
(013 LEVEL)

TOP OF FWD
STACK
147'-9 3/4" ABV BL
(013 LEVEL)

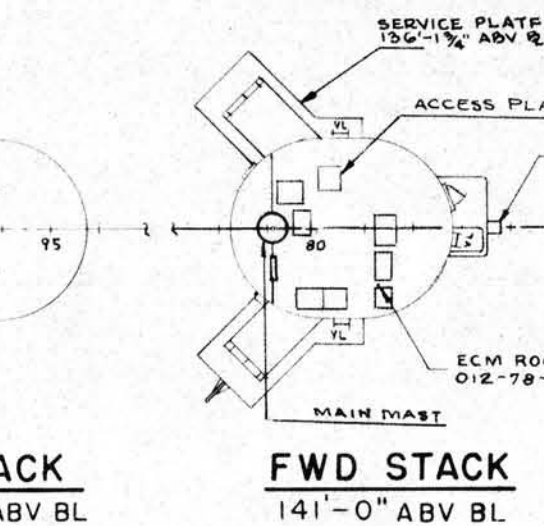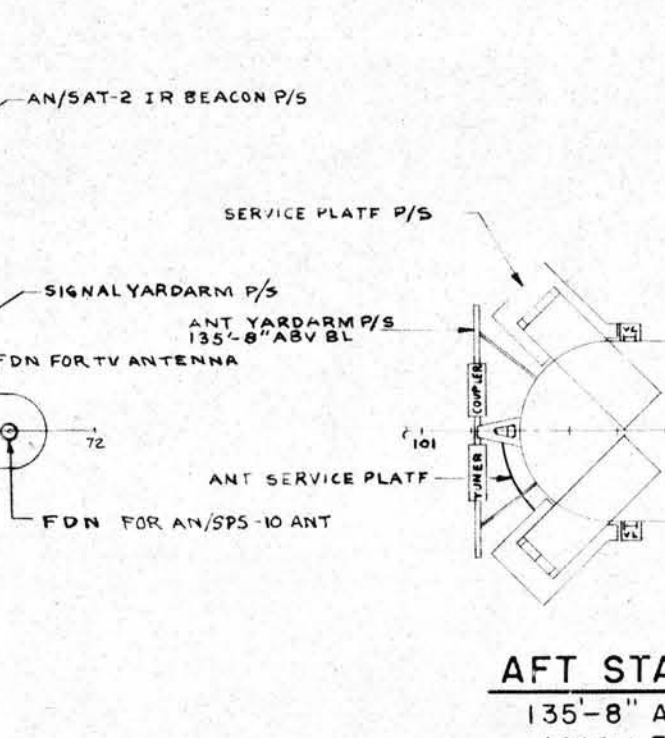

<u>BACK</u>	<u>FWD STACK</u>
ABV BL	141'-0" ABV BL
(LEVEL)	(012 LEVEL)


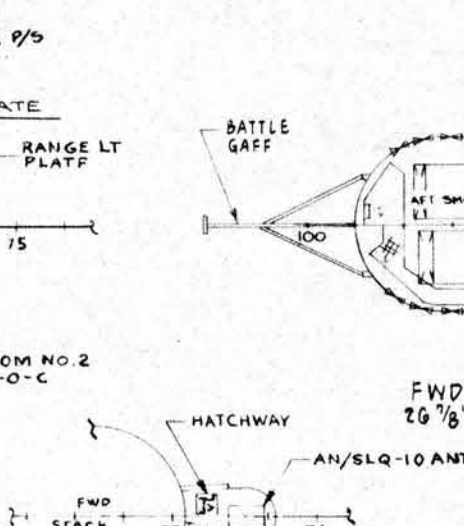


Diagram of the AN/SLQ-10 AN showing the FWD STACK, 77 TVL, and 74 components.

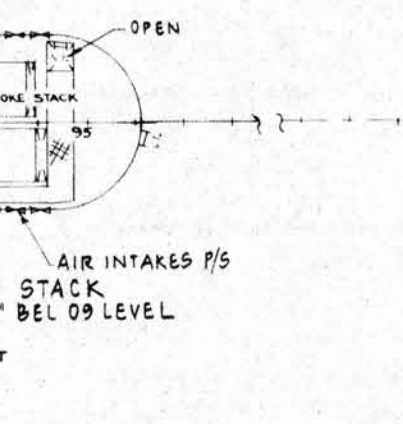


TOPPING LEAD BLOCK PLATE
108'-0 3/4" ABV BL

TOPPING FAIR LEAD & WINCH
CONTRA STA PLATE 107'-6 3/4" ABV BL

AIR INTAKES
P/S


BOAT HANDLING PLATE

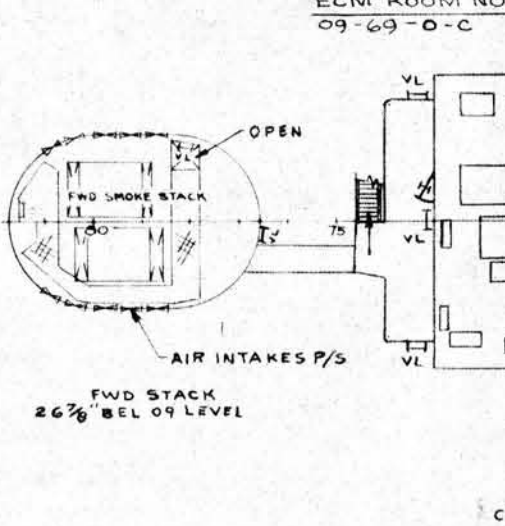


AN/SPS-30 EQPT.
COOLING ROOM
08-72-2-Q

AIR INTAKES P/S


VL

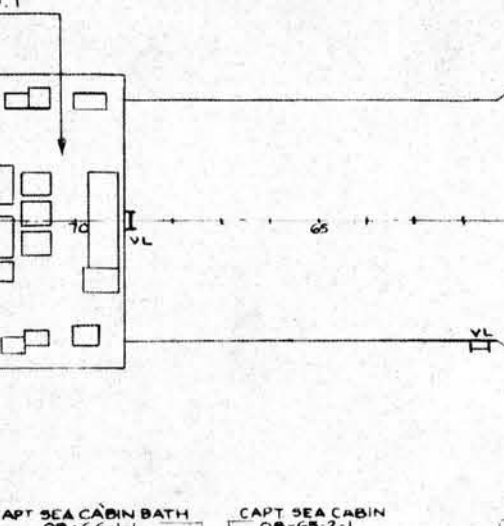



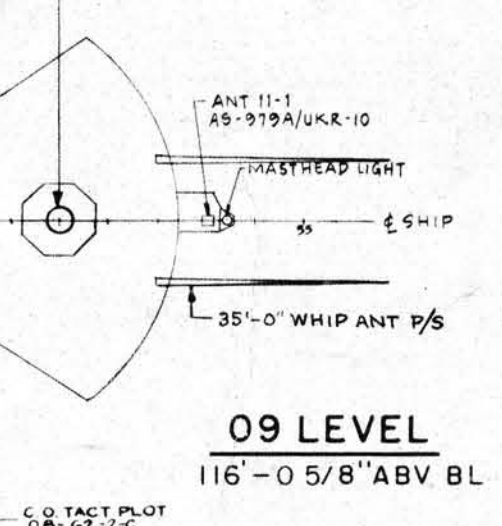


PILOT HOUSE
08-58-0-C
NON-ICING
WINDOWS P/S

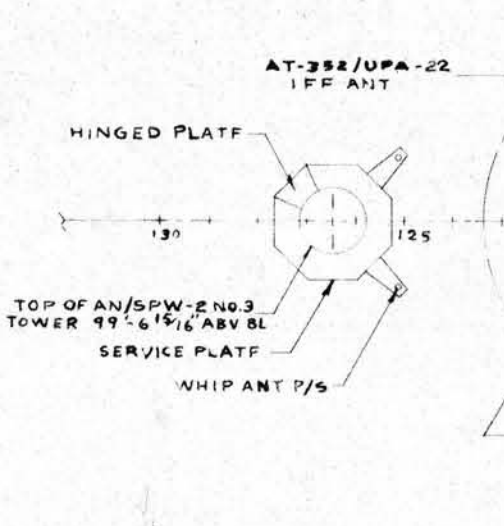




SERVICE PLATF 60" BEL
TOP OF TOWER

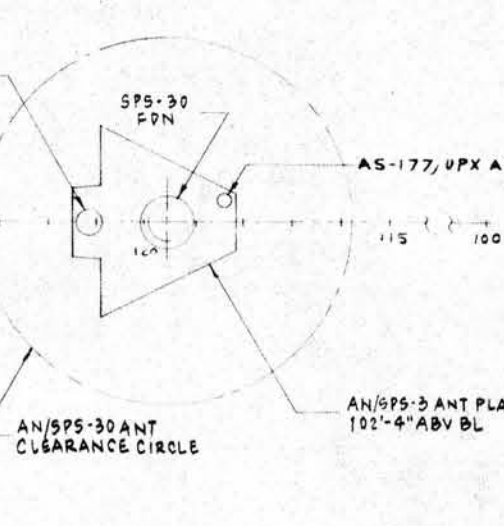

N/SPW-2 *3 TOWER

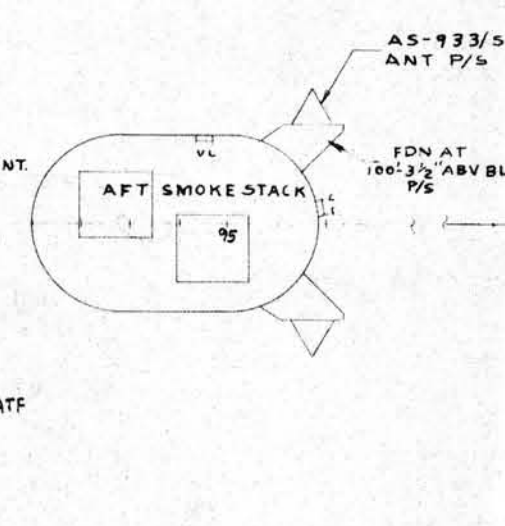

AS-933/SR
ANT P/S

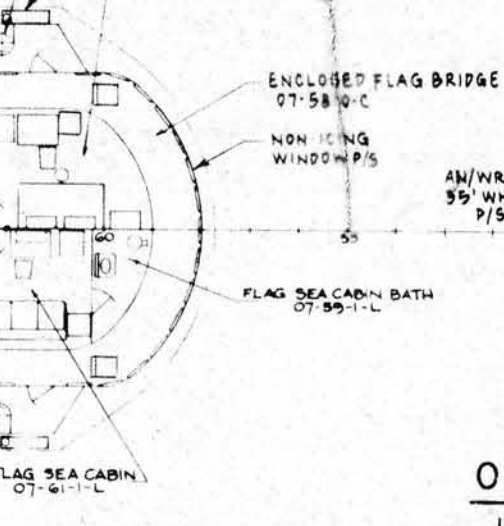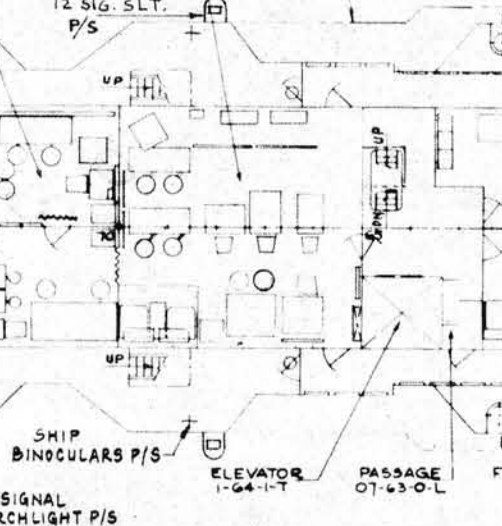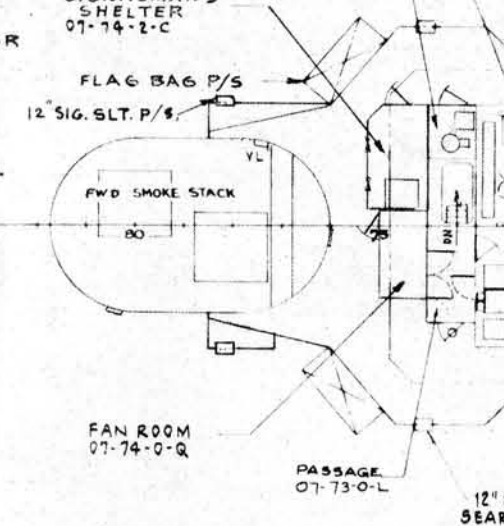


P/S


AEW ANT P/S

COMM ADMIN OFFICE & C


06 38-0 Q

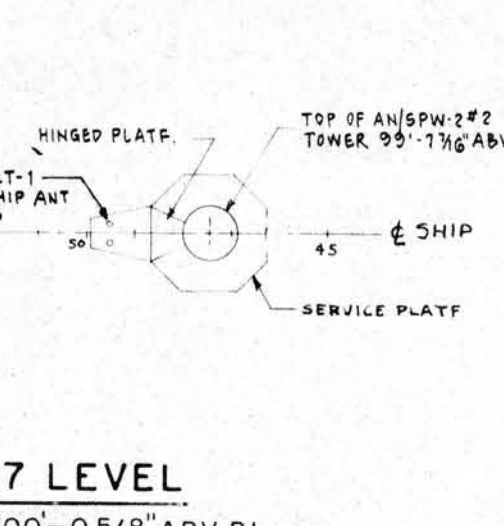


AN/SPW-2 #2 TO

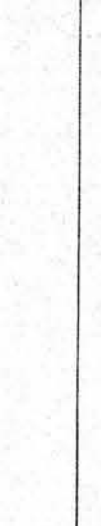

~~CONFIDENTIAL~~
CG 11-845-1072834
06 LEVEL 8 ABOVE
SCALE 1/16"=1'-0"
PLATE 5 OF 16

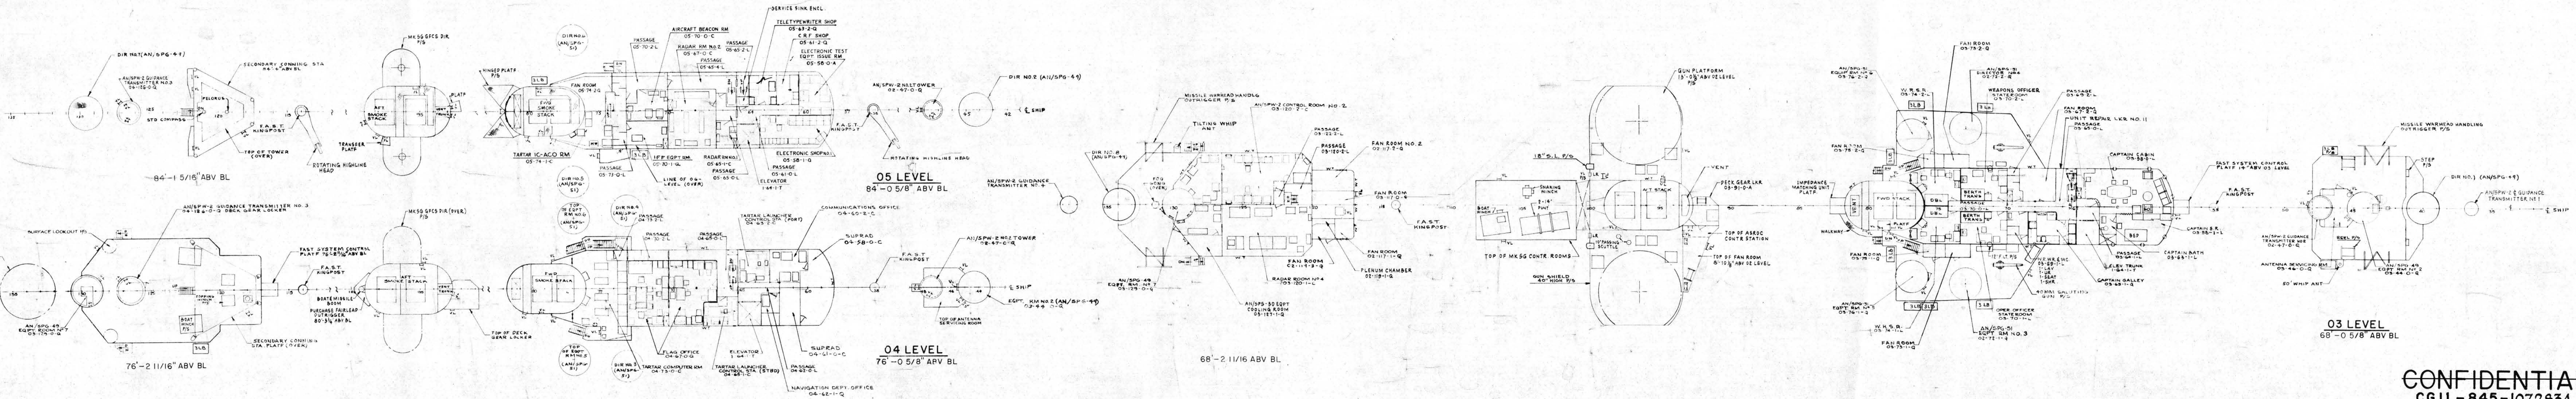

CONFIDENTIAL

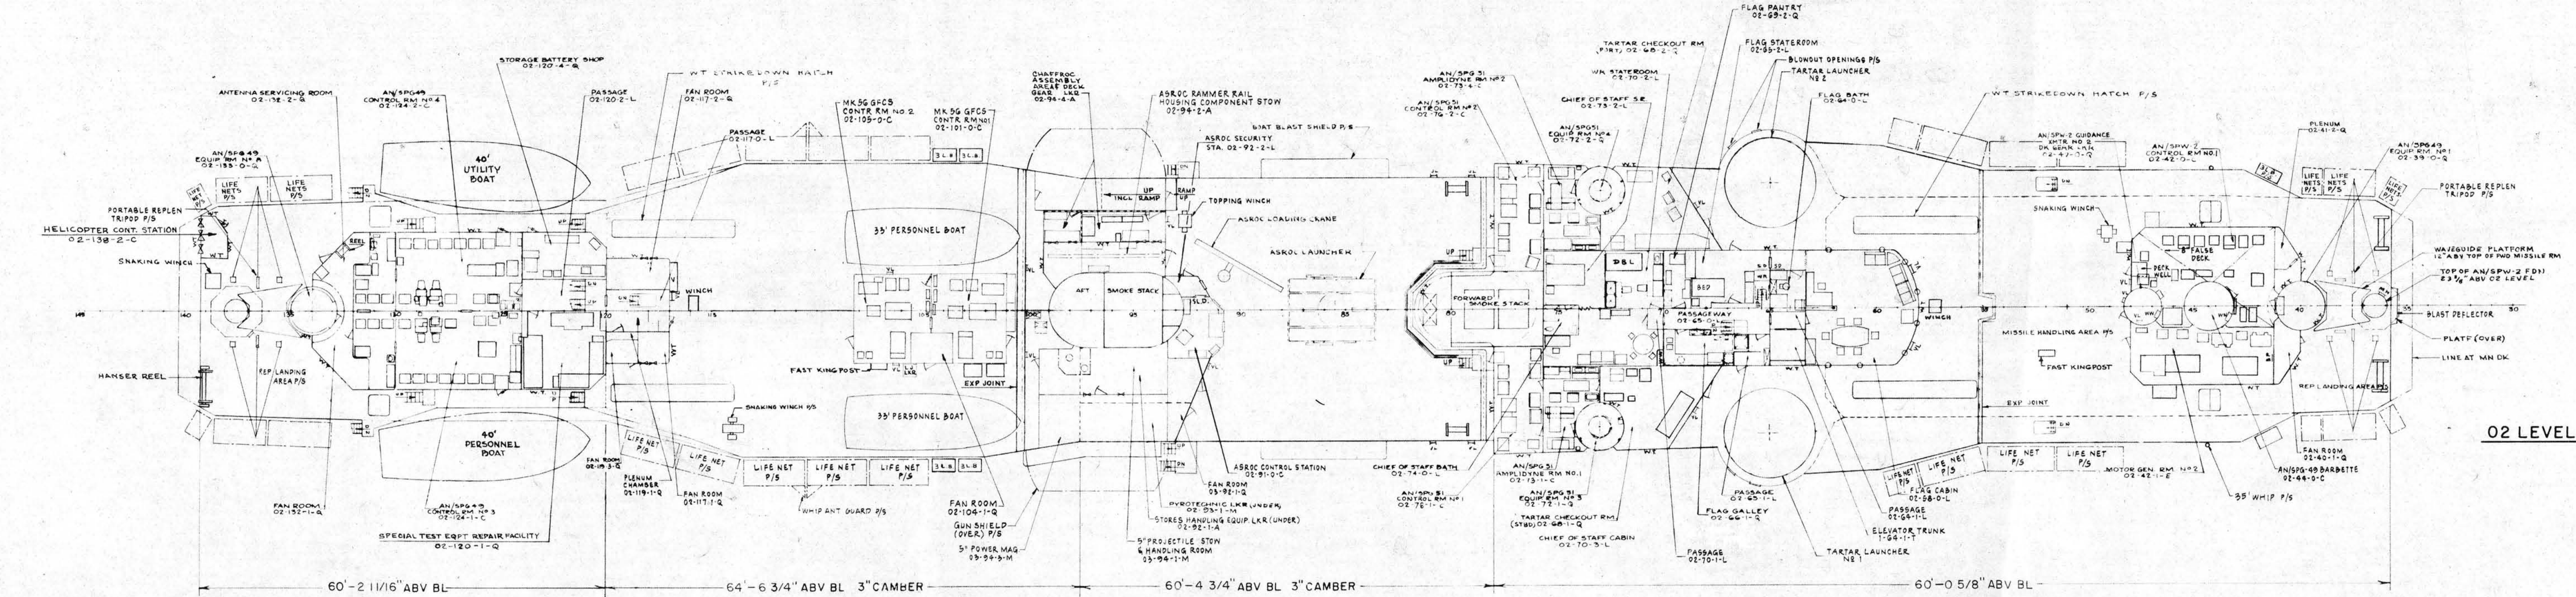


02 LEVEL

CONFIDENTIAL
CG11-845-1072834
02 LEVEL
SCALE 1/16"=1'-0"
PLATE 7 OF 16

CONFIDENTIAL
CG 11 - 845 - 1072834
OI LEVEL
SCALE 1/16"=1'-0"
PLATE 8 OF 16


CONFIDENTIAL
CGII - 845-1072834
MAIN DECK
SCALE 1/16"=1'-0"
PLATE 9 OF 16

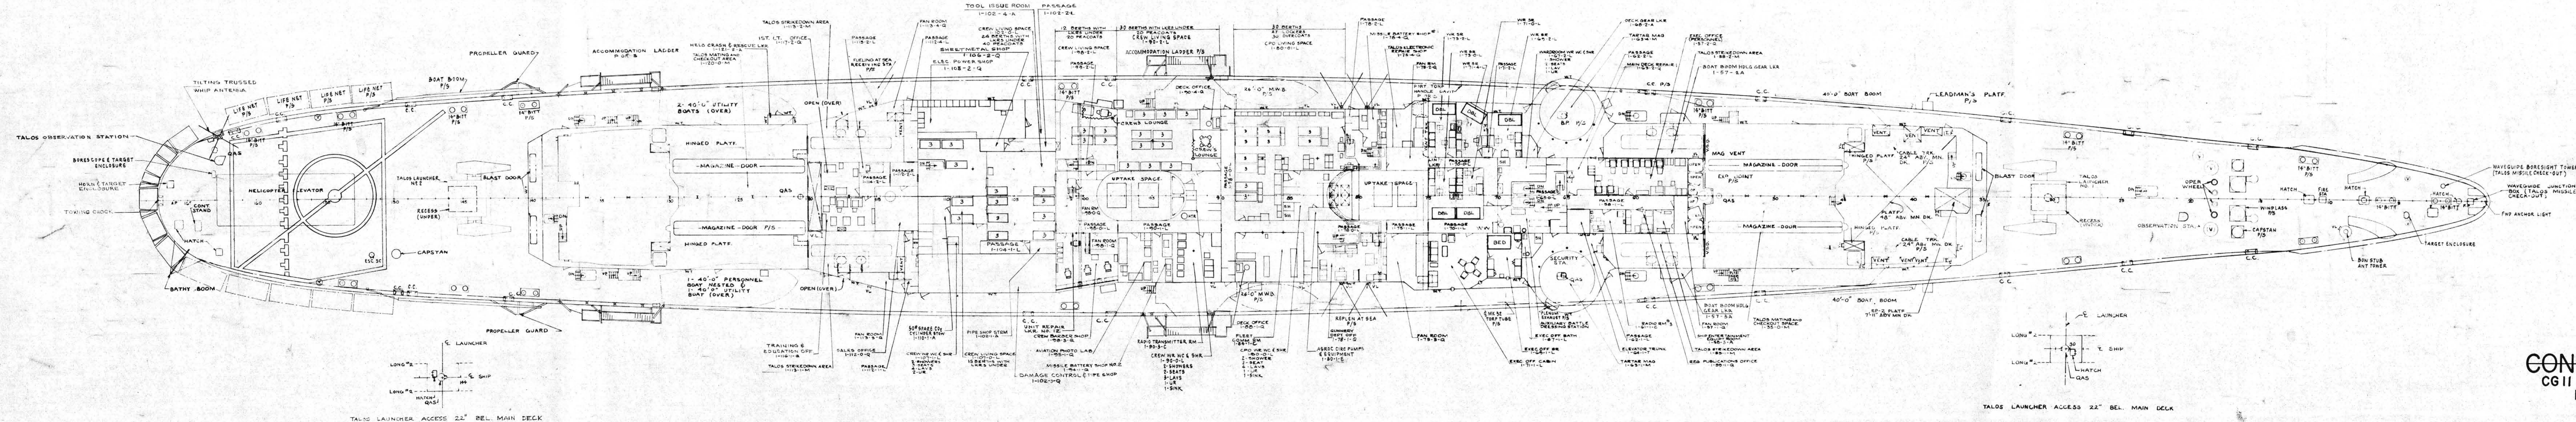

~~CONFIDENTIAL~~
CG11-845-1072834
SECOND DECK
SCALE 1/16"=1'-0"
PLATE 10 OF 16

~~CONFIDENTIAL~~
CG 11-845-1072834
THIRD DECK
SCALE 1/16"=1'-0"
PLATE 11 OF 16


CONFIDENTIAL

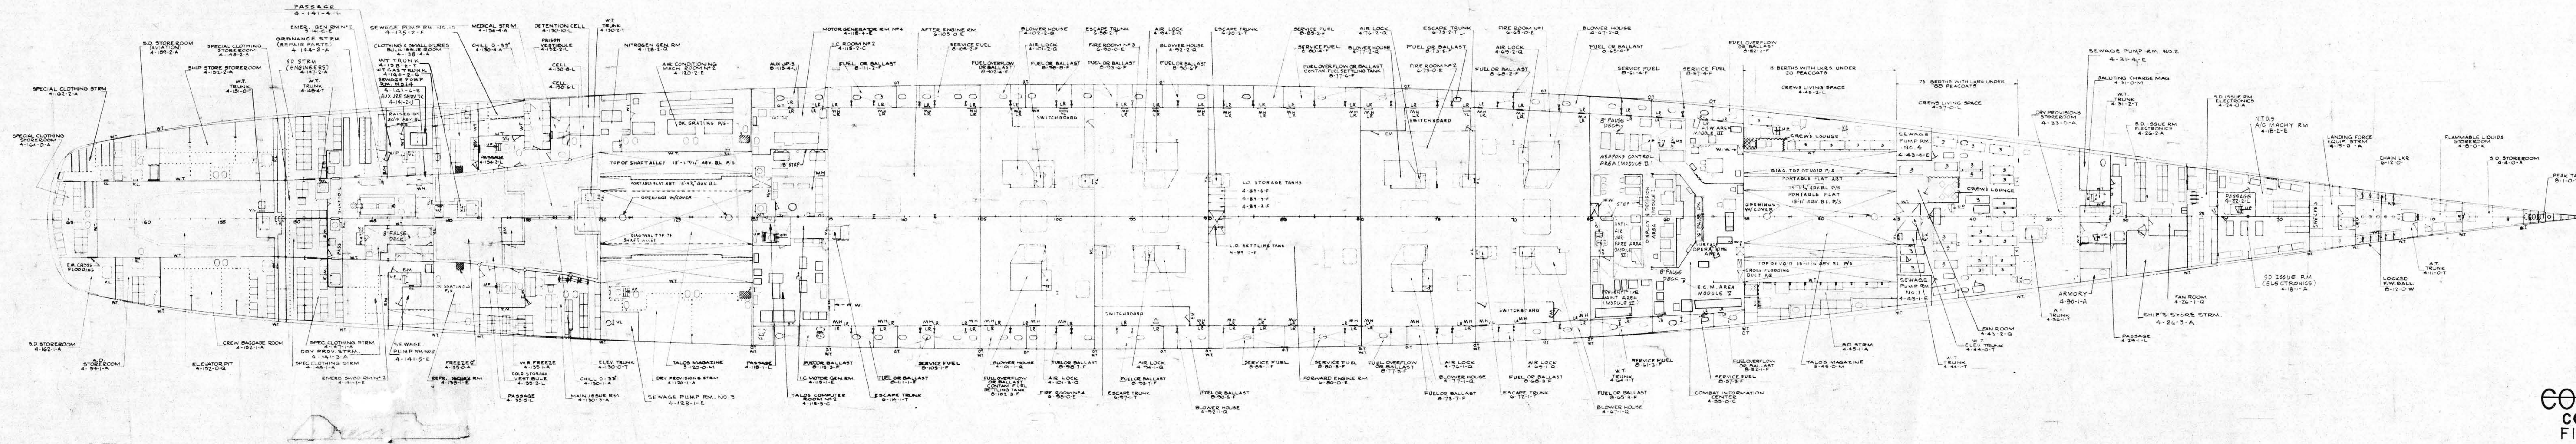

CONFIDENTIAL
CG11-845-1072834
FIRST PLATFORM
SCALE 1/16"=1'-0"
PLATE 12 OF 16

CONFIDENTIAL
CG 11-845-1072834
SECOND PLATFORM
SCALE 1/16"=1'-0"
PLATE 13 OF 16


CONFIDENTIAL

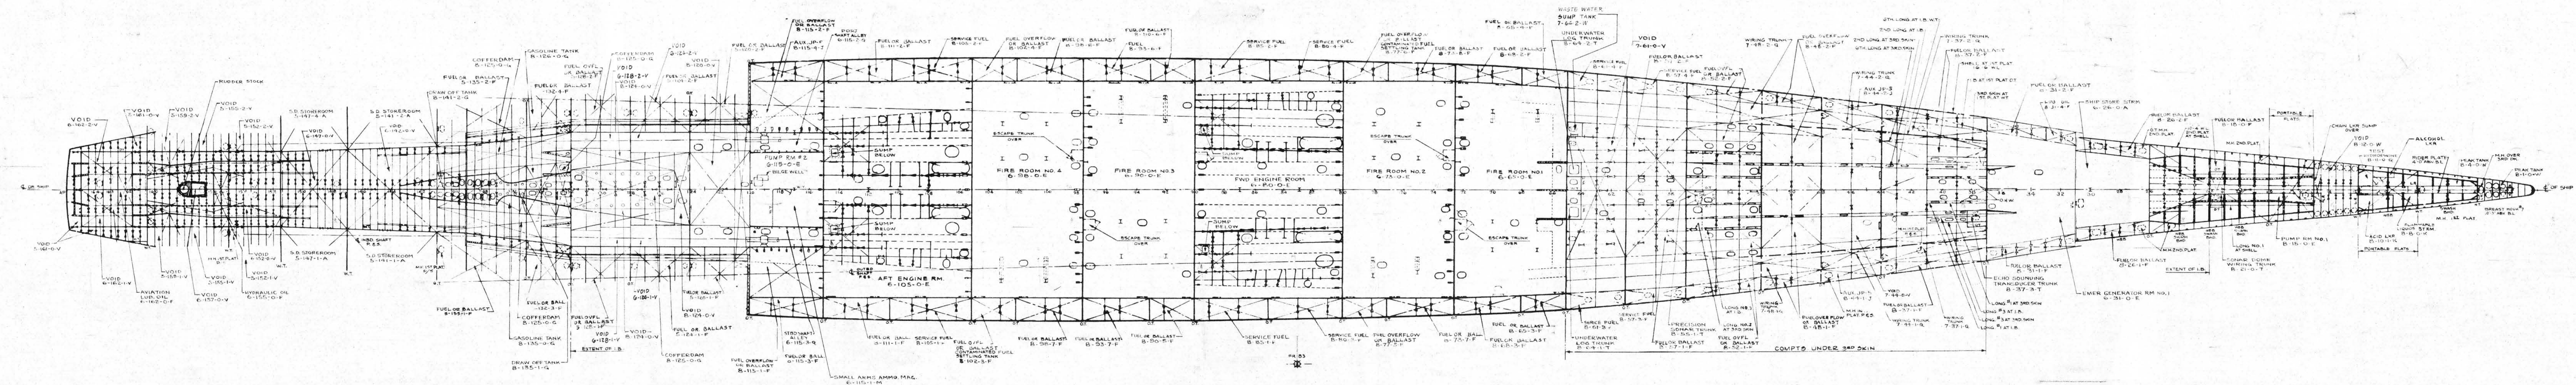


CONFIDENTIAL
CGII-845-1072834
HOLD
SCALE 1/16"=1'-0"
PLATE 14 OF 16

~~CONFIDENTIAL~~
CGII-845-1072834
INNER BOTTOM
SCALE 1/16"=1'-0"
PLATE 15 OF 16


CONFIDENTIAL

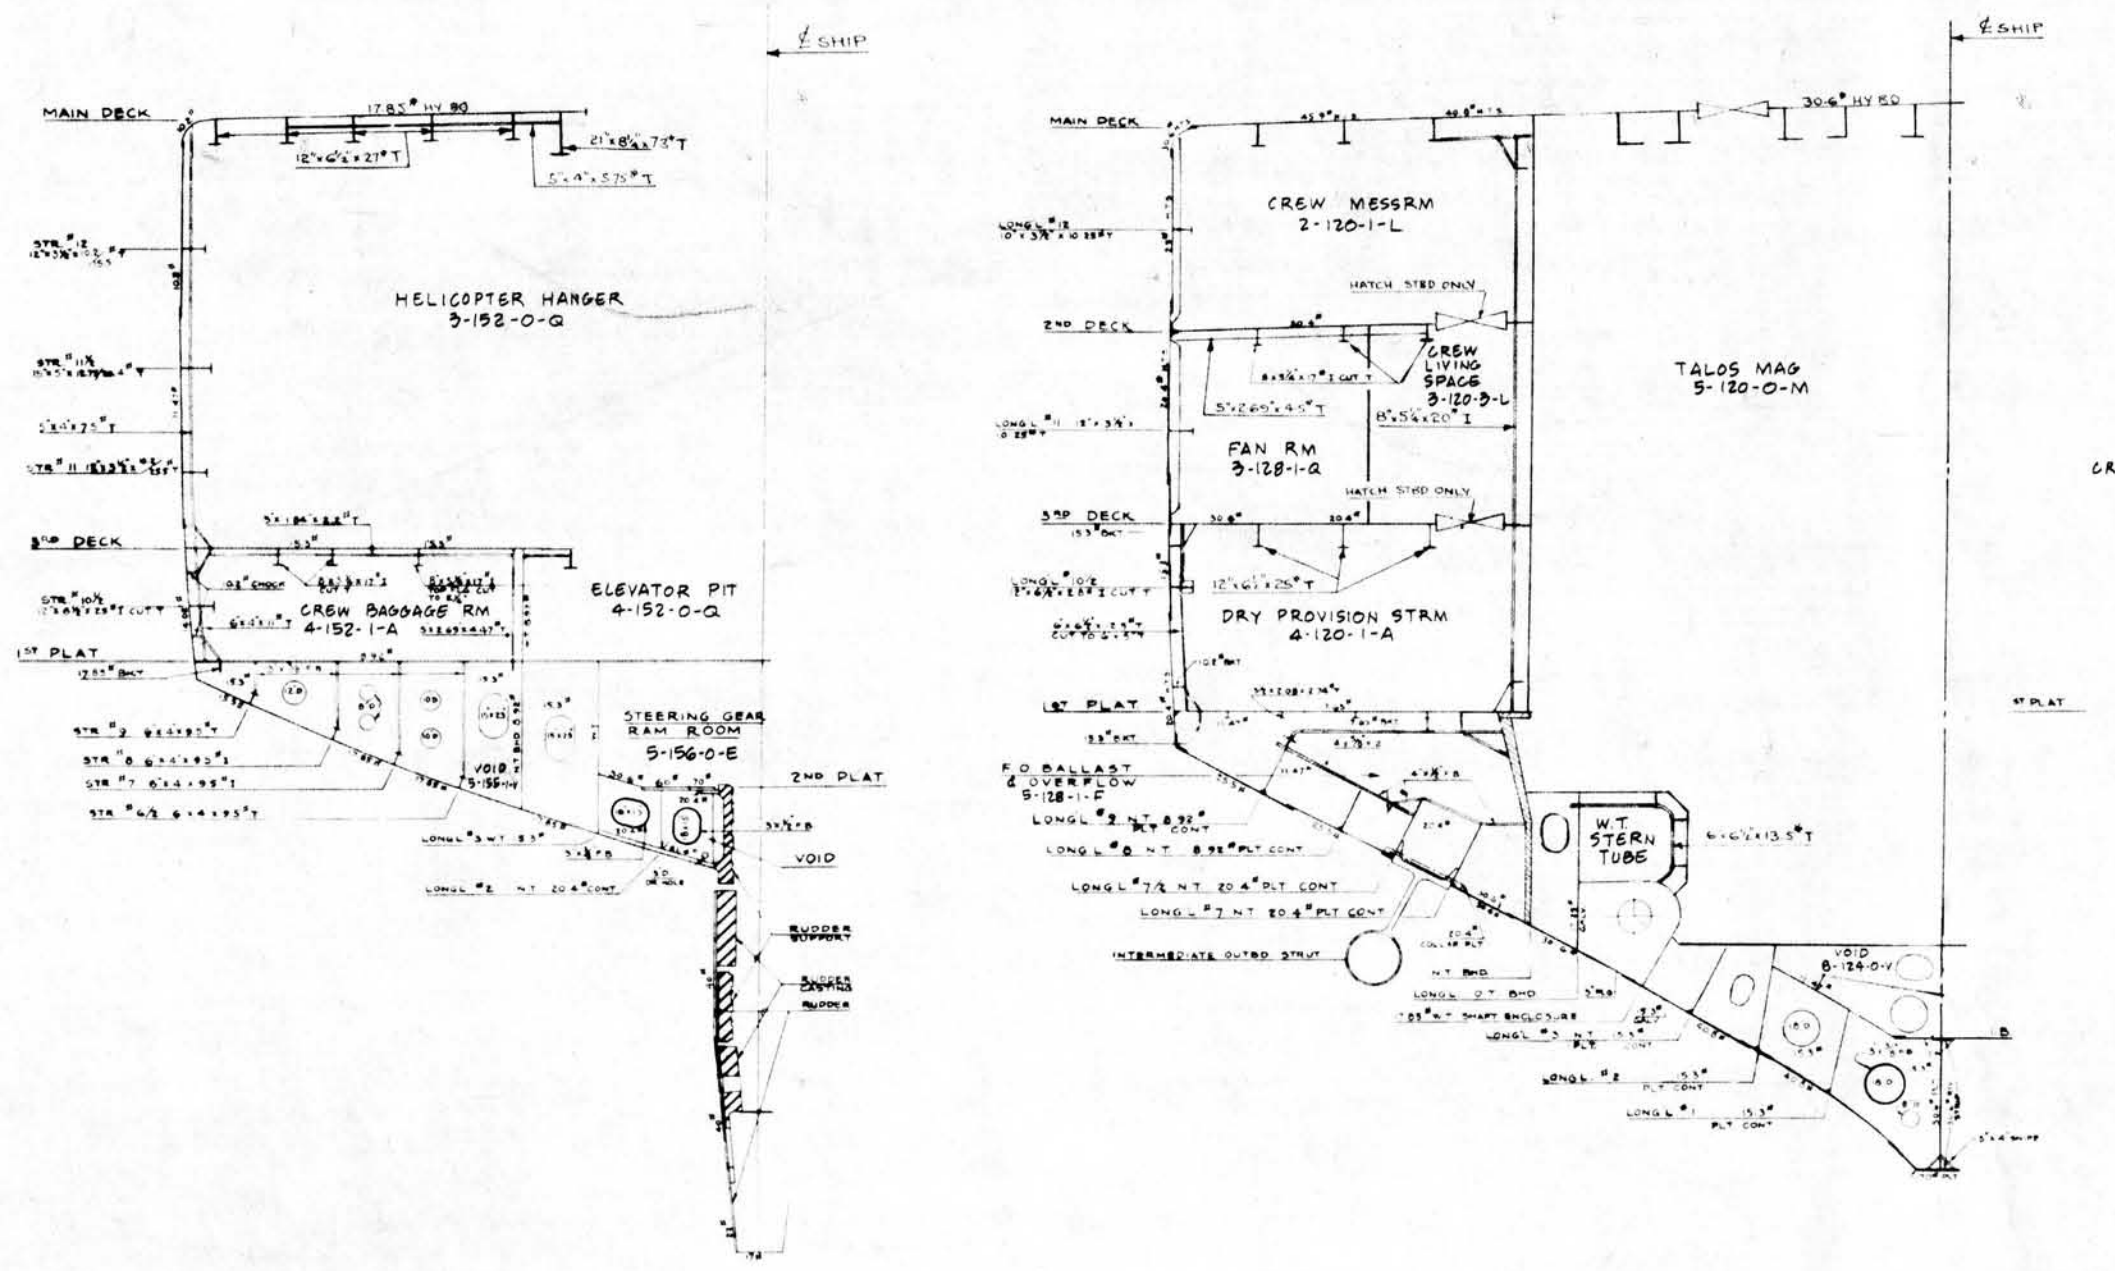


FRAME 158
LKG AFT

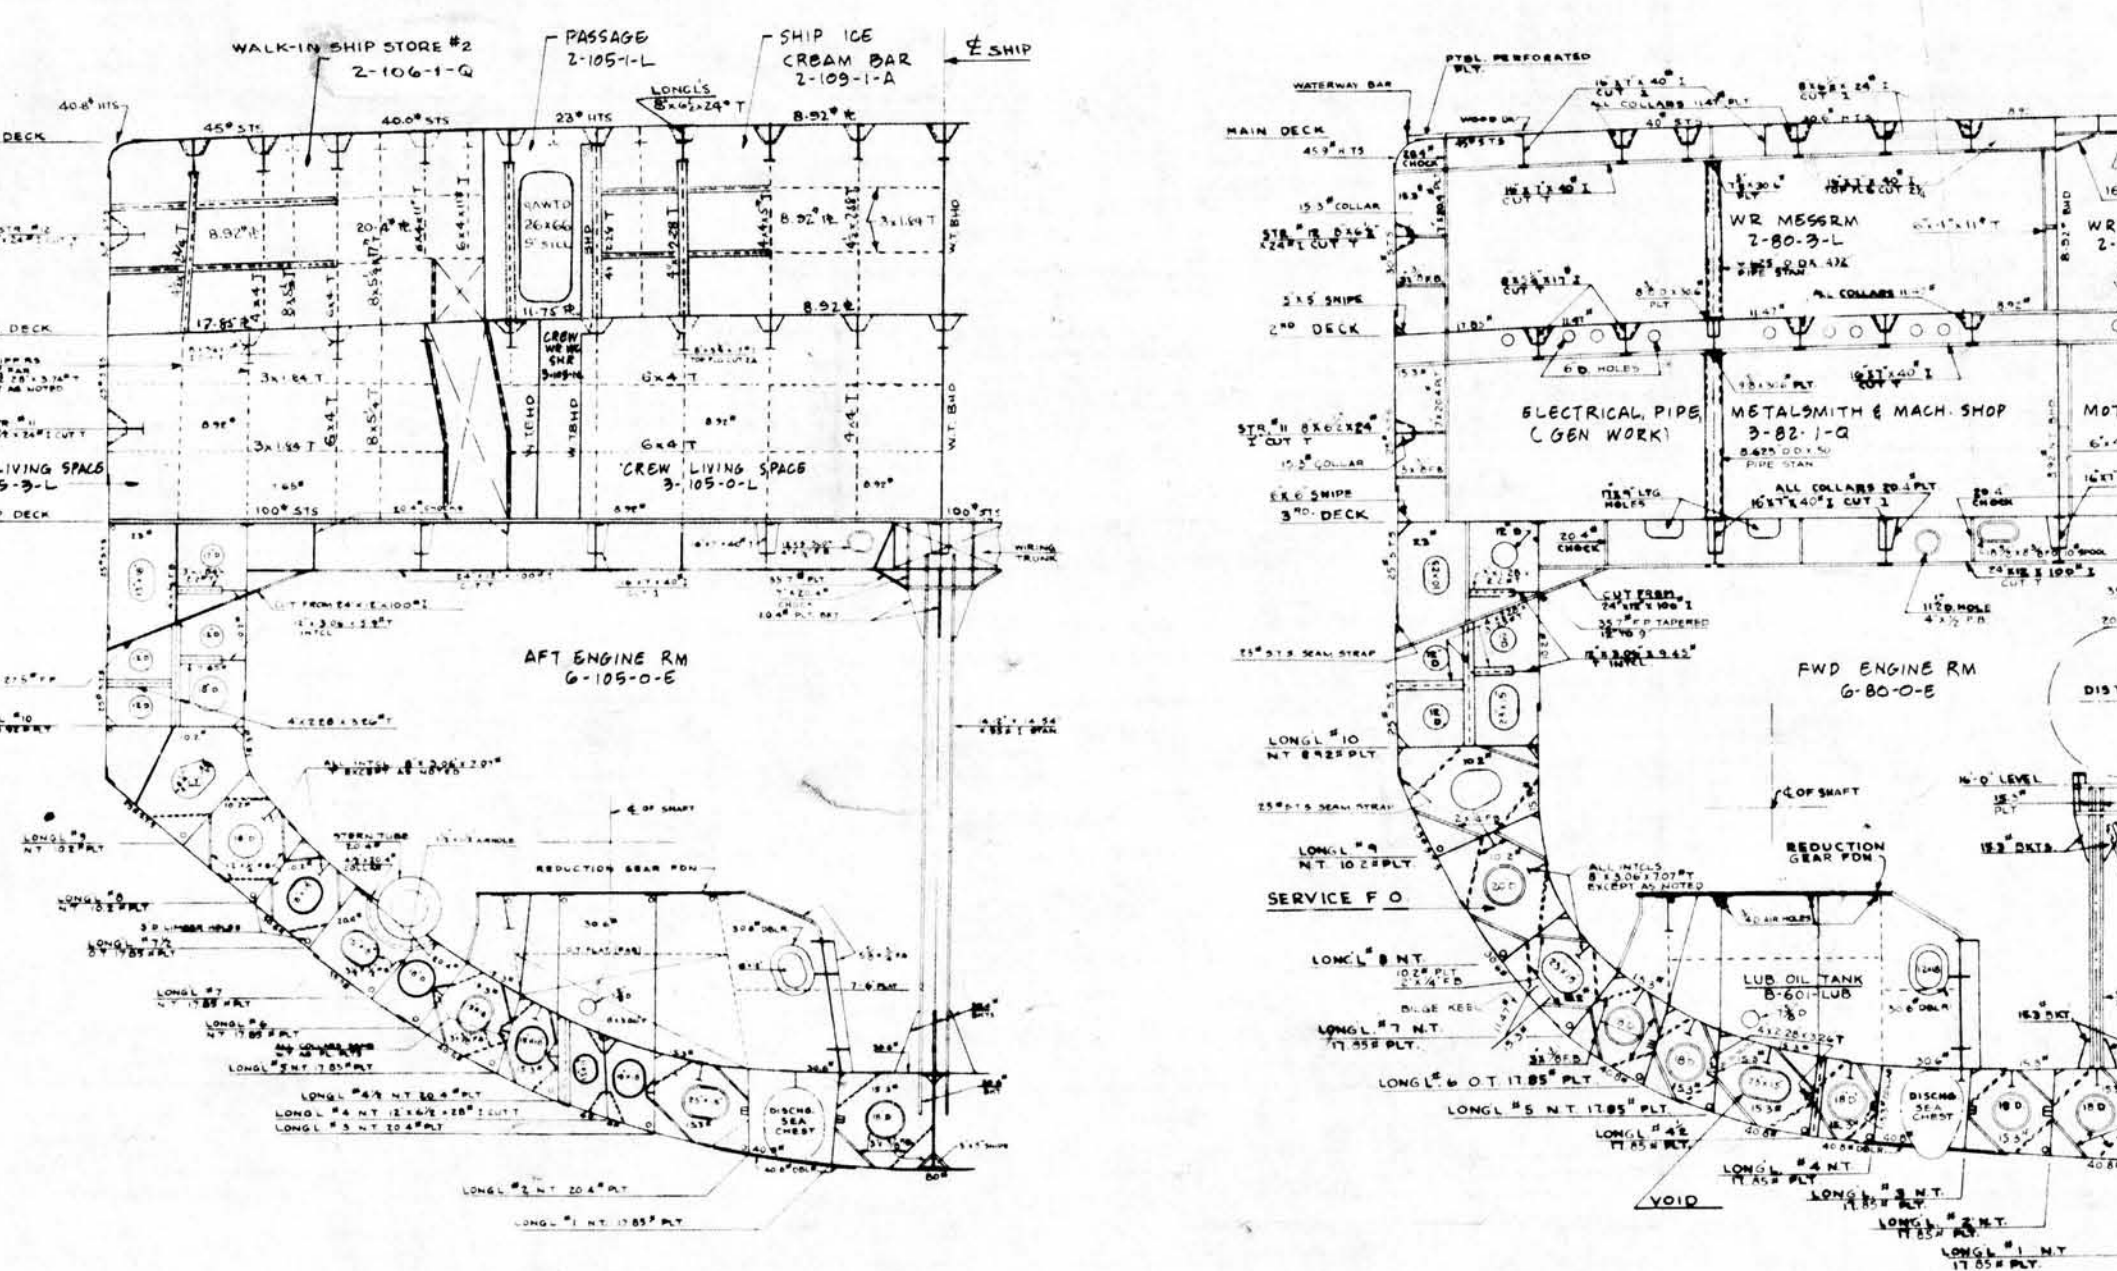


FRAME 129
LKG AFT

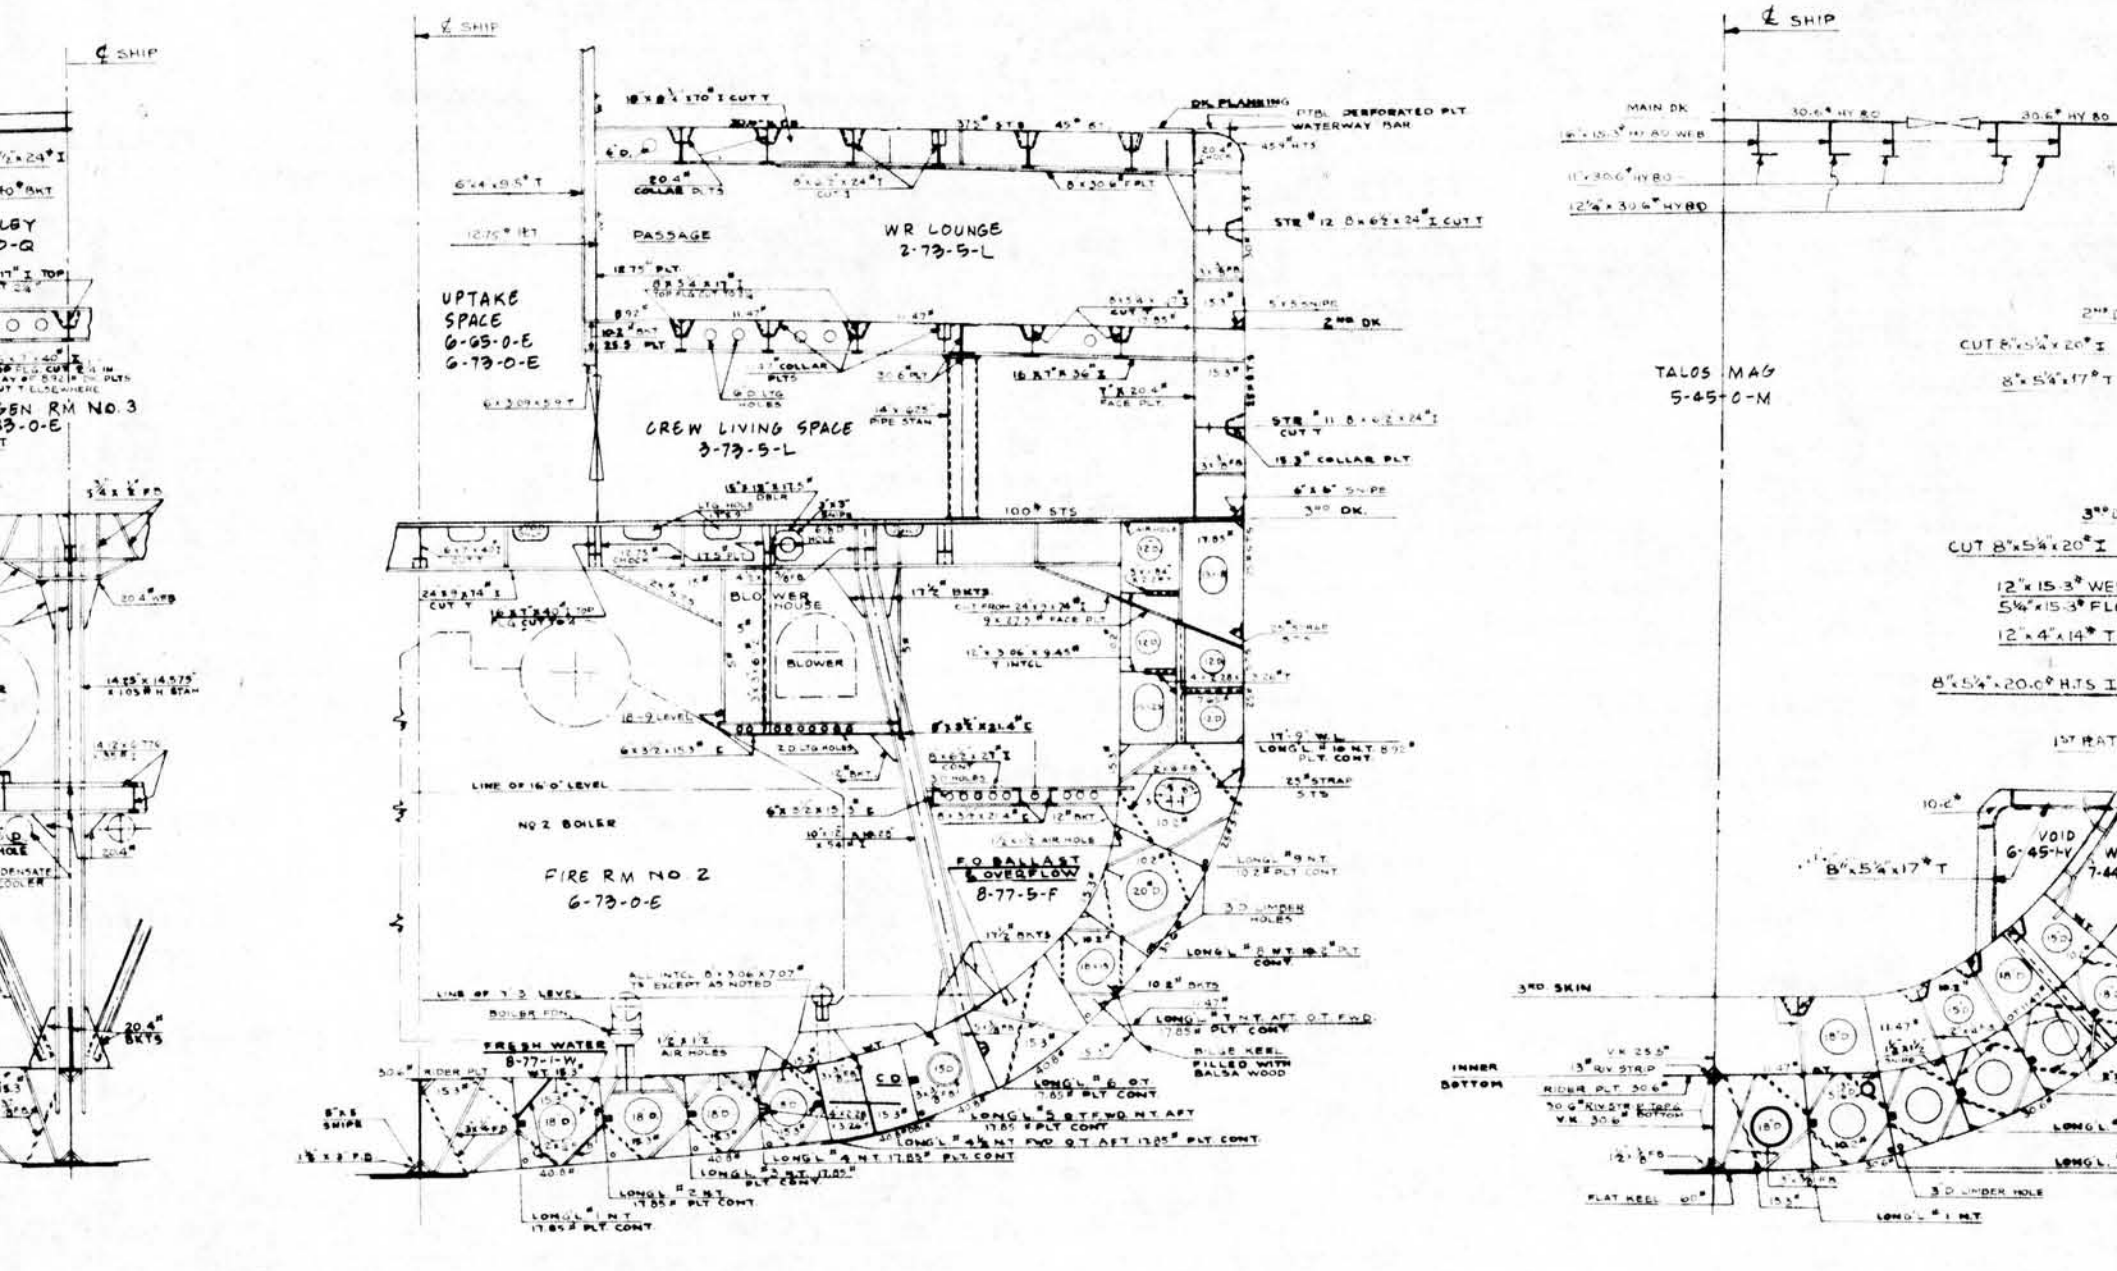

FRAME 112
LKG AFT

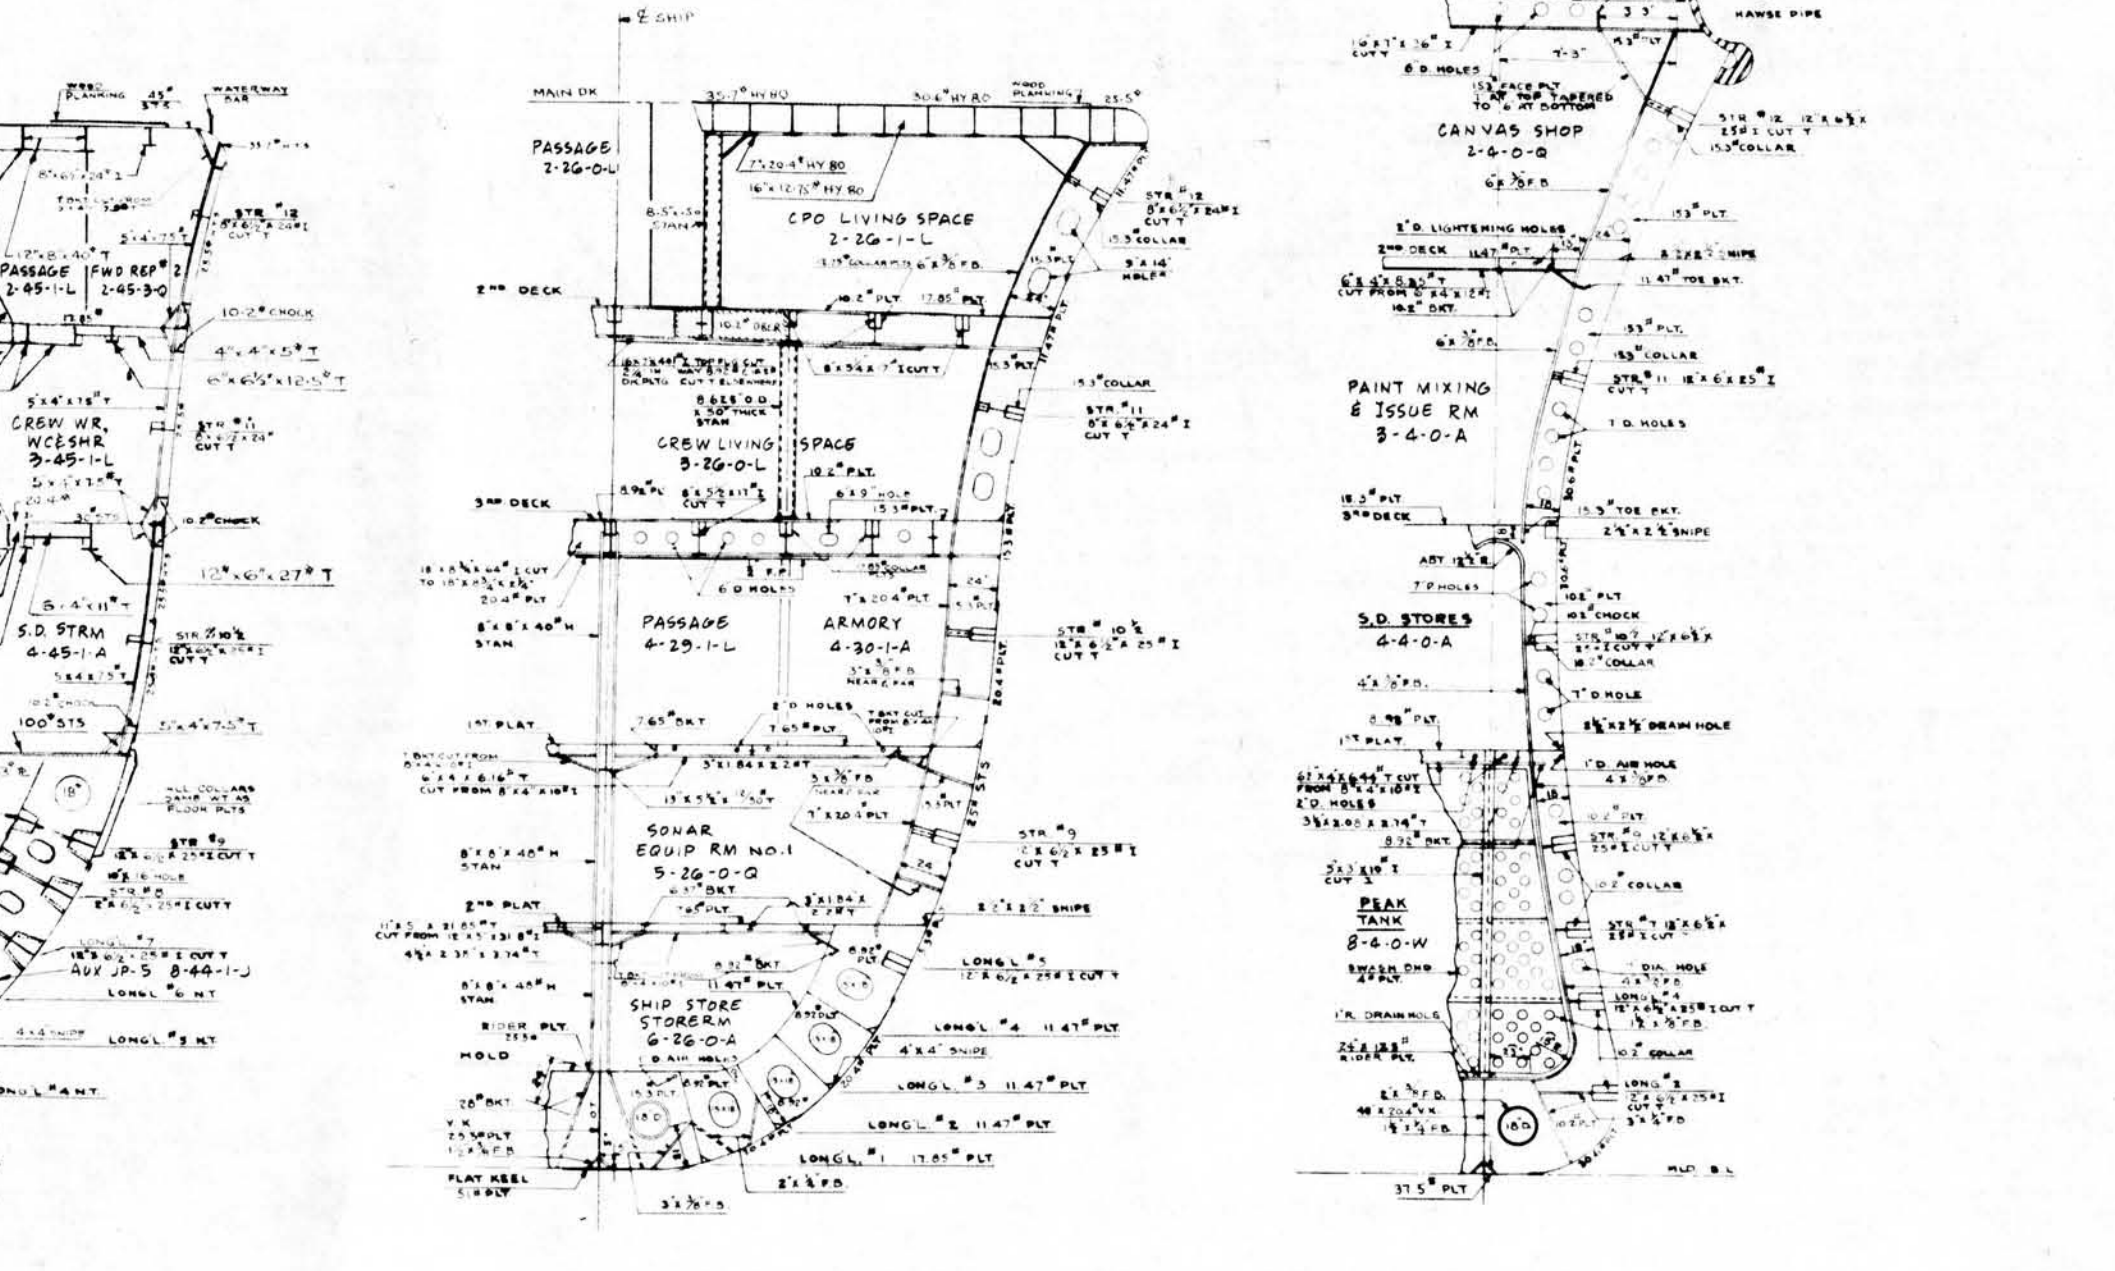

FRAME 87
LKG AFT

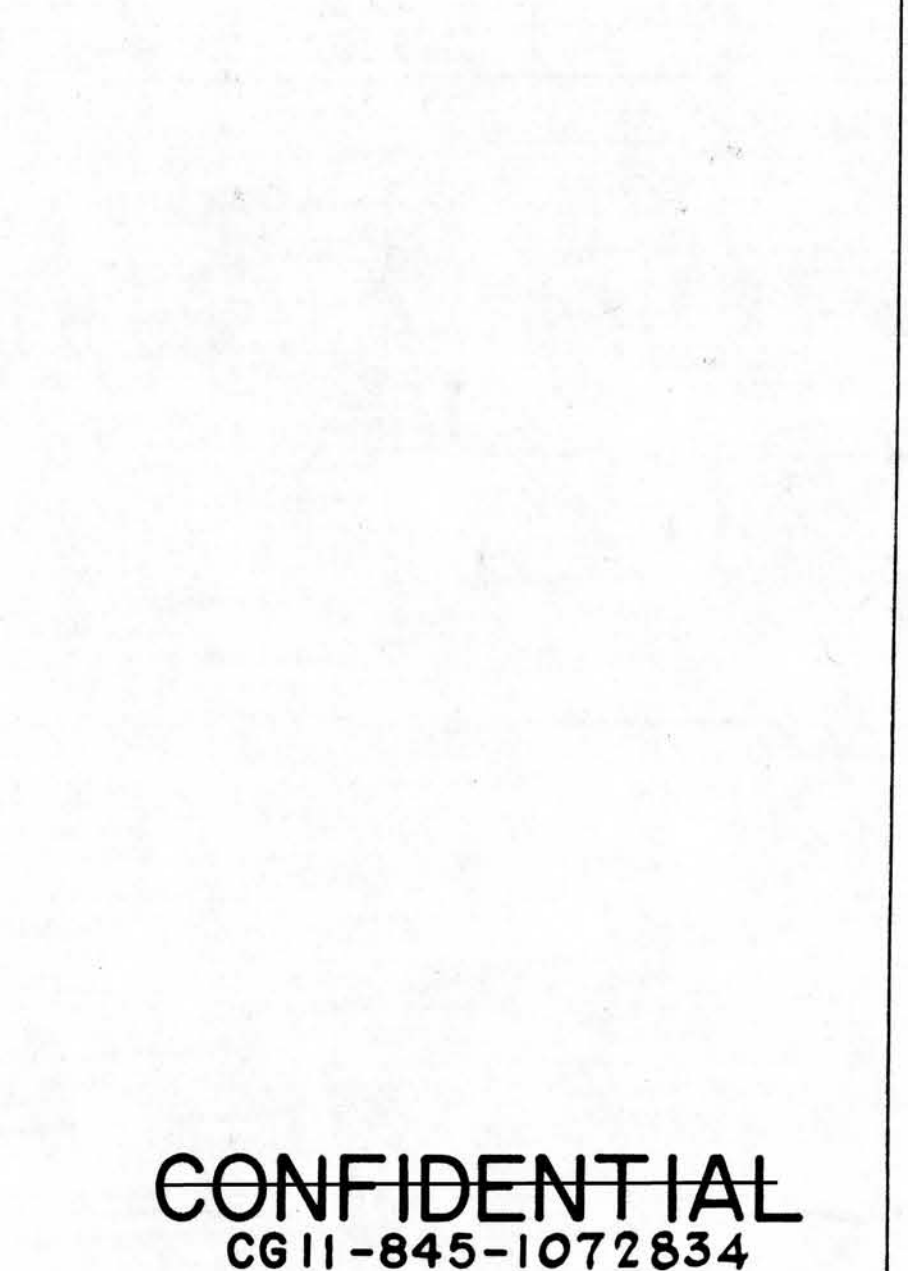

FRAME 78
LKG FWD

FRAME 46
LKG FWD

FRAME 30
LKG FWD

FRAME 6
LKG FWD

CONFIDENTIAL
CG11-845-1072834
TYPICAL SECTIONS
SCALE 1/16"=1'-0"
PLATE 16 OF 16